

5/42

DART AEROSPACE LTD	Work Order:	24500
Description: Lanyard Assembly	Part Number:	D2690- X
Drawing: D2690 Rev. B1 B2	Qty:	X = 17 5

Step	Location	Procedure	By	Date	Qty
1	EXPEDITING	Open W/O Complete X in the title block with the required length for the lanyard.	DL	05/10/12	5
2	STORES	Pick: Qty Part Number Description Batch 2 CBL-460 Loop Sleeve M18473 X" + 2.5" CBL-1240 Cable M16713 Value for X is stated above in title block	DL	05/10/28	5
3	METAL	Assemble as per Dwg D2690	DL	05/10/28	5
4	QC	Inspect Level 7	DL	05/10/31	5
5	STORES	Identify and stock	DL	05/11/31	5
6	EXPEDITING	Close W/O Cost / part: 6.10 o/c 05/11/01 (5) Inspect Level 21 2.98	DL	05/11/01	5

Rev	Date	Change	Created By	Approved
A	98.05.08	New Issue	KB	
B	99.02.09	Added Inspection Level	DM	
C	01.08.24	Removed Manufacturer Release Certification	SM	PC

RELEASED


01.08.24

W/O:		WORK ORDER CHANGES							
DATE	STEP	PROCEDURE CHANGE		By	Date	Qty	Approval Mfg / Design Mgr	Approval QC Inspector	

NCR:		WORK ORDER NON-CONFORMANCE (NCR)							
DATE	STEP	Description of NC Section A	Corrective Action		Section B		Verification Section C	Approval Design Mgr	Approval QC Inspector
			Initial Design Mgr	Action Description Design Mgr		Sign & Date			

Part No: _____ PAR #: _____ Fault Category: _____


NOTE: Date & initial all entries

NCR: Yes ☒ No ☐ DQA:  Date: 05/11/01
QA: N/C Closed: _____ Date: _____



DESIGN <i>ME</i>	DRAWN BY <i>KE</i>	DART AEROSPACE LTD VICTORIA INTERNATIONAL AIRPORT, CANADA	
CHECKED <i>ME</i>	APPROVED <i>BW</i>	DRAWING NO. D2690	REV. B SHEET 1 OF 1
DATE 97.10.02		TITLE LANYARD ASSEMBLY	SCALE NTS
A	97.07.03	NEW ISSUE	
B	97.10.02	REVISED NOTE FOR ADDITIONAL LENGTH	
B1	CP 01.08.20	ADD NOTE TO REMOVE 2.25" OF SLEEVE	
B2	R 04.06.24	ADDED TOLERANCE	

RELEASED
971003 KE
TSR A374

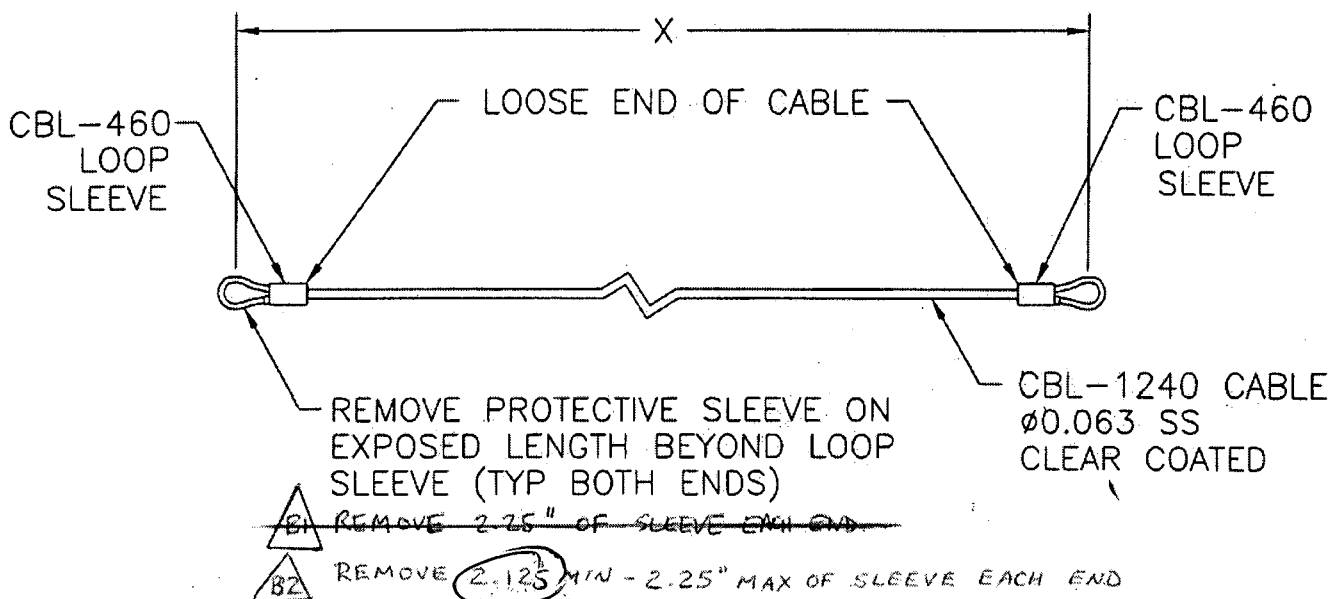

D2690-X

X = LENGTH IN INCHES

NOTE: CUT CABLE 2.50* INCHES LONGER THAN 'X' LENGTH. FOLD ENDS TIGHT TO 'X' LENGTH AND CRIMP WITH SLEEVE AT END OF LOOSE END OF CABLE WITH CBL-705 CRIMPING TOOL.

*ADDITIONAL LENGTH MAY BE NECESSARY IN SOME APPLICATIONS. CUT AS REQUIRED.

NOTE: IN SOME CASES, END HAS TO BE CRIMPED AFTER ASSEMBLY WITH ATTACHING PARTS.

WORK ORDER

NO. 24500

DEO's

Job Costing Report

Dart Aerospace Ltd.
Hawkesbury

Oct 11, 2005
07:41 am

Work Order No : 0024500
Project Name : D2690-17
Project For : WK542
Work Order Type : Main
Main WO Number :
House Part Number : D2690-17
Description : Cable
Manufactured : Yes
Amount Req'd : 5
Amount Done : 0
Start Date : 10-08-05
Est Finish Date : 10-20-05
Act Finish Date :
Drawings Req'd : No
Ok for Approval :
Approval Rec'd :

Department Code:
Burden Flags : NNNNNNNN
WO Status : Open
Invoice State : Not Invoiced
Invoice Date :
Invoice Number :
Invoice Amount : 0.00
Order Entry No :
OE Value : 0.00
Est Mark Up : 0.000%
Actual Mark Up : 0.000%
\$0 Posted to Finished Goods

	Estimated	Actual	Var. %	Posted	To Post
Material Cost :	0.00	0.00	0.00	0.00	0.00
Engineering Hours :	0.00	0.00	0.00		
Engineering Cost :	0.00	0.00	0.00	0.00	0.00
Production Hours :	0.00	0.00	0.00		
Production Cost :	0.00	0.00	0.00	0.00	0.00
Packaging Hours :	0.00	0.00	0.00		
Packaging Cost :	0.00	0.00	0.00	0.00	0.00
OverHead Hours :	0.00	0.00	0.00		
OverHead Cost :	0.00	0.00	0.00	0.00	0.00
CNC Hours :	0.00	0.00	0.00		
CNC :	0.00	0.00	0.00	0.00	0.00
Misc. Hours :	0.00	0.00	0.00		
Misc. :	0.00	0.00	0.00	0.00	0.00
Burden :	0.00	0.00	0.00		
Total Cost :	0.00	0.00	0.00		
Mark up :	0.000	0.000			
Selling Cost :	0.00	0.00			

	Estimated	Actual
Labour Hrs/Amount Done :	0.00	0.00
Profits/(Loss) :	0.00	0.00